

NOTICE TO BIDDERS
ADDENDUM #2
TOWNSHIP OF RANDOLPH, MORRIS COUNTY, NEW JERSEY
CALAIS ROAD PARK
BID OPENING DATE – JUNE 29, 2018, 11:00 A.M.

NOTICE IS HEREBY GIVEN that sealed bids for the Calais Road Park project for the Township of Randolph, County of Morris, State of New Jersey will include an acknowledgement of ADDENDUM #2. The ACKNOWLEDGEMENT OF RECEIPT OF CHANGES TO BID DOCUMENTS FORM included in the bid specifications must be completed and returned with the bid package. The Addendum shall become part of the original specifications and is to be attached thereto.

This Addendum is being issued in response to bidders' questions and to include an additional sketch:

Q1. There is an item drawn with the Community Garden that is described as a "Potting Bench" on Sheet 3, but as a "Work Table" on Sheet 19. Please clarify whether this item is a Potting Bench and should be included with Bid Item No. 43, if this is an additional item, or if this is something the Township is supplying.

A1. The Potting Bench and Work Tables are the same item. The item is to be provided as shown on the Sheet 19 in the detail titled "Potting Bench" and should be included in Bid Item No. 43.

Q2. Is there a specific manufacturer for the bollards that the township would like used?

A2. There is no specific manufacturer.

Q3. Are you issuing new bid forms? Item 69 & 70 are identical.

A3. Pay Item 70 should be changed to "Landscape plantings – Trees and Shrubs – 1 Lump Sum". Use the attached replacement sheet P-15.

Q4. Which bid item is to get plantings (trees & Shrubs)?

A4. The trees and shrub plantings is Item 70. (See Q3/A3 above)

Q5. Is on-site soil considered suitable for re-use?

A5. The on-site soils can be reused as general fill as long as they are adequately protected from too much moisture or freezing.

Q6. Please confirm thickness of topsoil that goes back to disturbed areas. Plans show 6", 5" and 4".

A6. 5" minimum thickness of topsoil shall be spread.

Q7. Can on-site materials be used as topsoil without any additives? Screening?

A7. On-site topsoil can be used on the project. Additives are not required to be blended in with the topsoil. Contractor shall screen topsoil prior to reuse.

Q8. Are the Concrete Pads for Structures to be paid under Item 19 or under their respective item numbers (Romtec Building, Bandshell, Shade Structures, Octagonal Structure)?

A8. They are to be paid under their respective items.

Q9. Have you done a cut & fill calculation? If so, what is it?

A9. No cut and fill analysis has been done. That is the bidder's obligation.

Q10. Restroom ceiling, are there ceilings in the restrooms or is it just roof structure?

A10. There are no ceilings in the restrooms.

There is a crosswalk that should have been included on the plans. The attached is an addendum to Sheet 3 of the project drawings.

Elizabeth Crescibene, RPPO, QPA
Purchasing Agent

SCHEDULE OF PRICES – cont'd

CALAIS ROAD PARK

70 1 LS Landscape plantings – Trees and Shrubs
 Price per Lump Sum

_____ Dollars
_____ Cents \$ _____ \$ _____


71 1 LS Sod and Seeded Lawn
 Price per Lump Sum

_____ Dollars
_____ Cents \$ _____ \$ _____

Total of Base Bid (Items 1-71) (in Words and Figures)

_____ \$ _____
(In Words) (In Figures)

COPYRIGHT © 2011 FRENCH & PARRELLO ASSOCIATES, P.A. THE COPYING OR REUSE OF THIS DOCUMENT OR PORTIONS THEREOF, WITHOUT THE WRITTEN PERMISSION OF FRENCH & PARRELLO ASSOCIATES, P.A. IS PROHIBITED. SEE TO AVOID ANY ERRORS IN REPRODUCTION. METHODS, ERRORS MAY OCCUR WHEN SCALING THIS DRAWING.

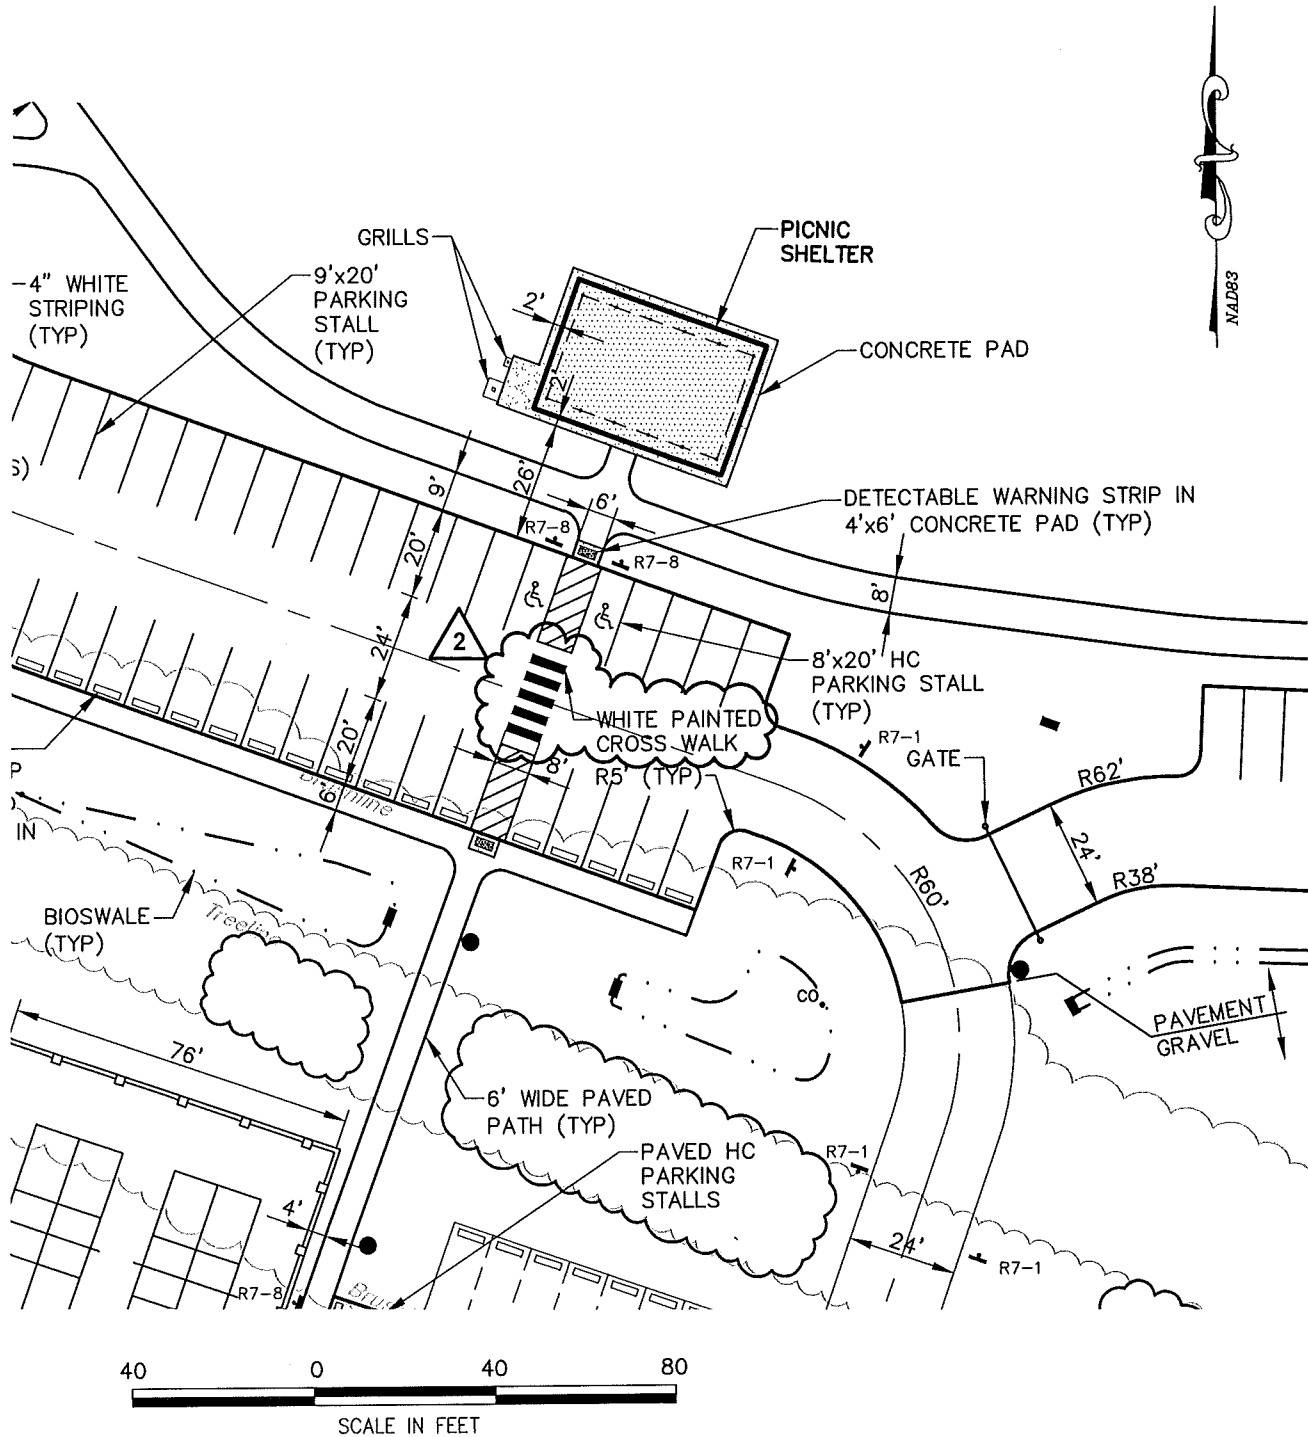

SHEET 3 - ADDENDUM 2
 FOR
CALAIS ROAD PARK
LOTS 2 & 3 BLOCK 49
 TOWNSHIP OF RANDOLPH
 MORRIS COUNTY NEW JERSEY

FPA
FRENCH & PARRELLO
 ASSOCIATES

Hackettstown Office
 43A Newburgh Road, Suite 100
 Hackettstown, NJ 07840
 908.850.0977
 Offices
 Corporate - Wall, NJ
 New York, NY

DATE: 06/19/18	DESIGNED BY: SKW	SCALE: AS NOTED	PROJECT NUMBER: 12259.001
DRAWN BY: SKW	CHECKED BY: DFK	FIELD BOOK -	SHEET: 1 of 1

G:\12K\12200\12259 - CALAIS RECREATION COMPLEX\12259.001 - REC COMPLEX\CADD\DWG\12259-01-SP1.DWG (ADDENDUM2)